LED SIGN - CENTERED ON BUILDING ENTRANCE BY ROAD. SMALL SIGN - TO THE RIGHT OF ENTRANCE

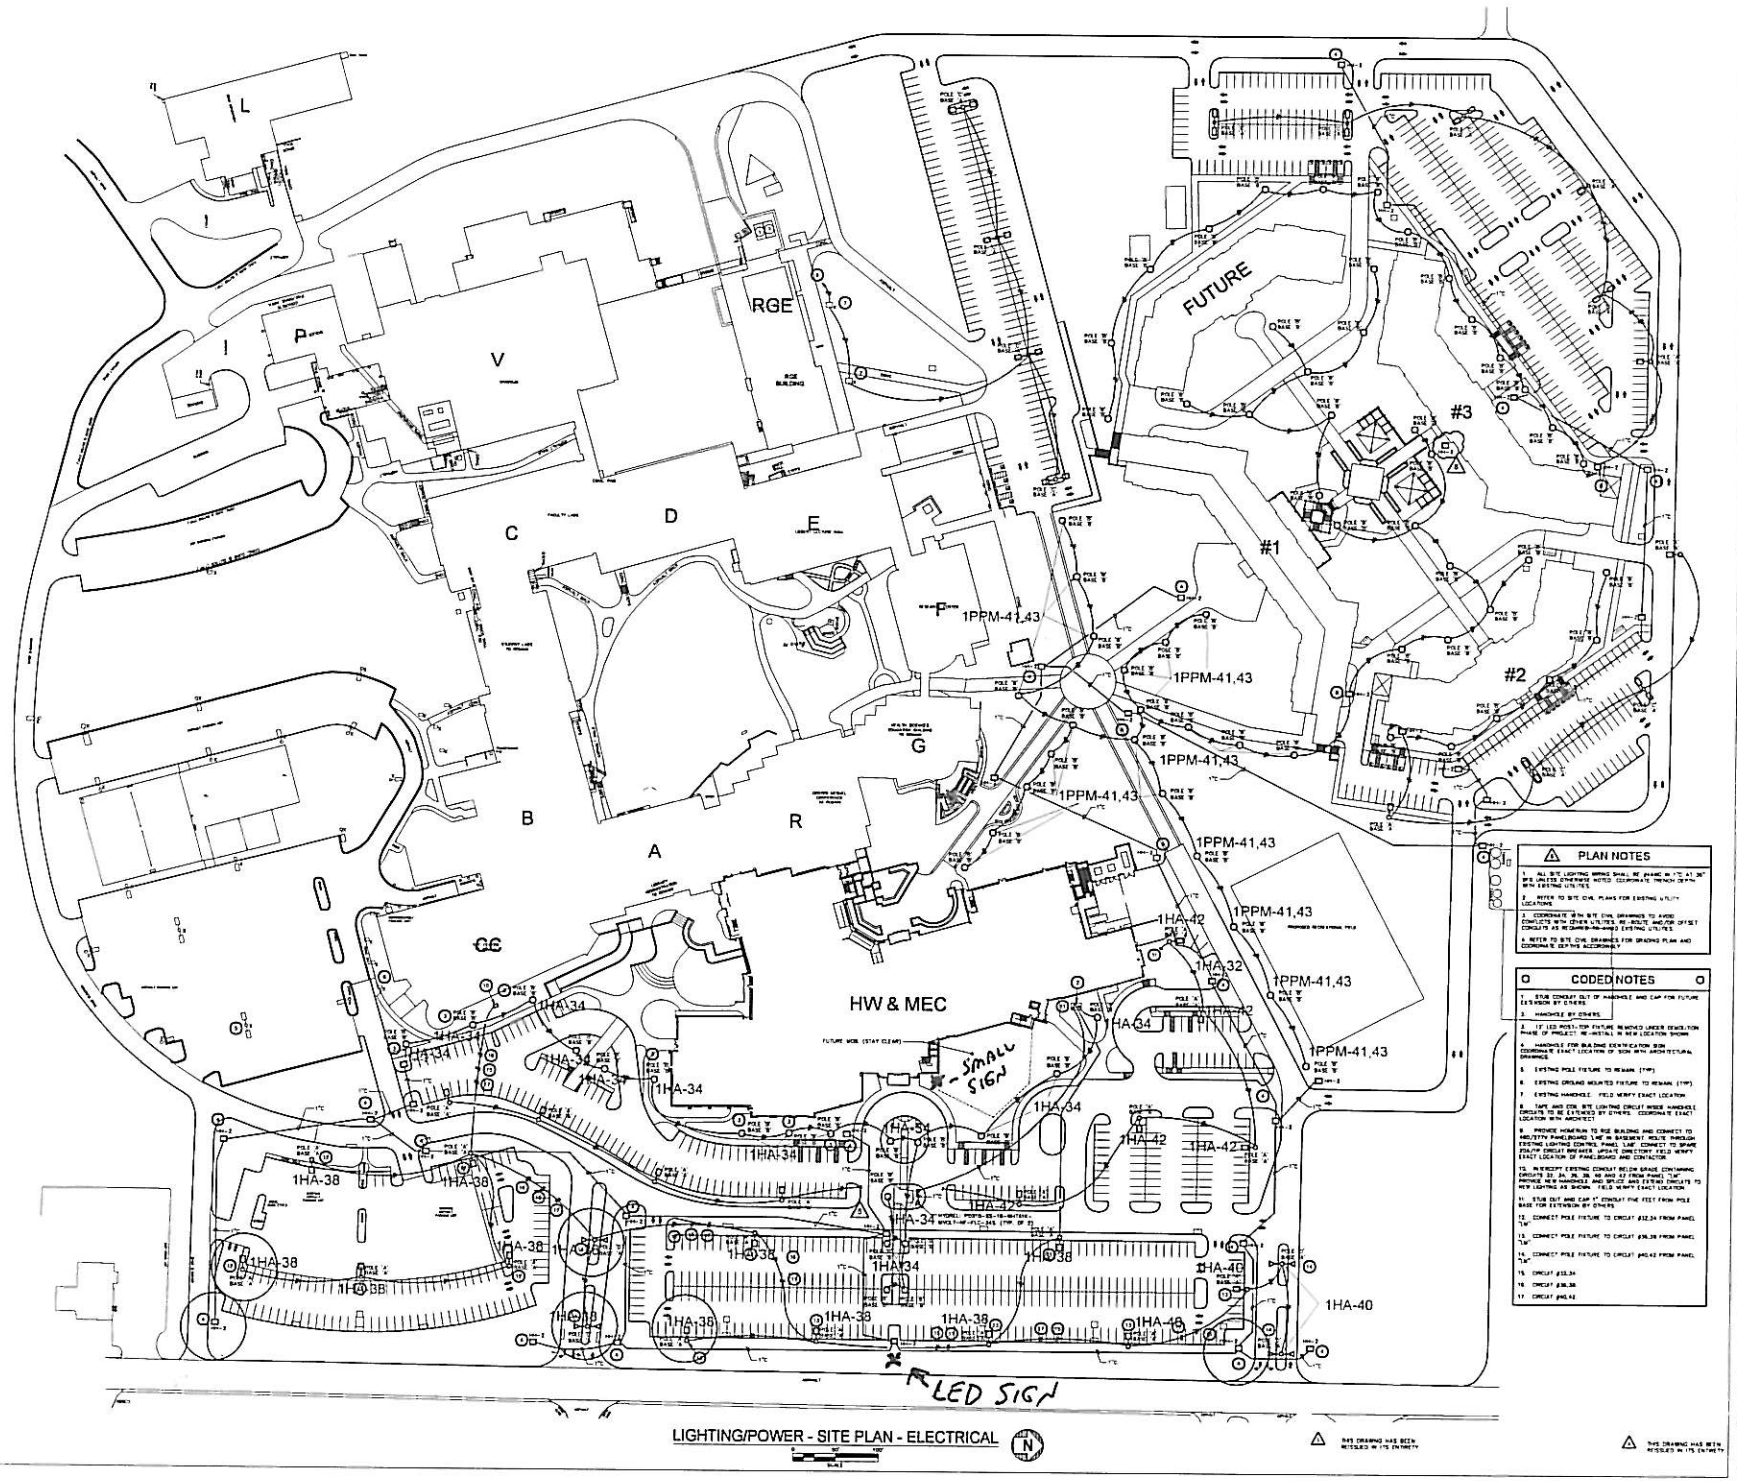

LIGHTING/POWER - SITE PLAN - ELECTRICAL

RECORD DRAWINGS 03/31/15

LIGHTING/COMMUNICATIONS - SITE PLAN - ELECTRICAL

SIGNET DEVELOPMENT
NEOMED HOUSING FACILITY- FULL SET

TC ARCHITECTS
759 WHITE POND DRIVE
SUITE 401
AKRON, OH 44320
PHONE: (330) 867-1093
FAX: (330) 867-4198
www.tcarchitects.com

TURNING VISIONS INTO REALITY

10/01/12
DATE

27B12
PROJECT NUMBER

E200
DRAWING NUMBER